
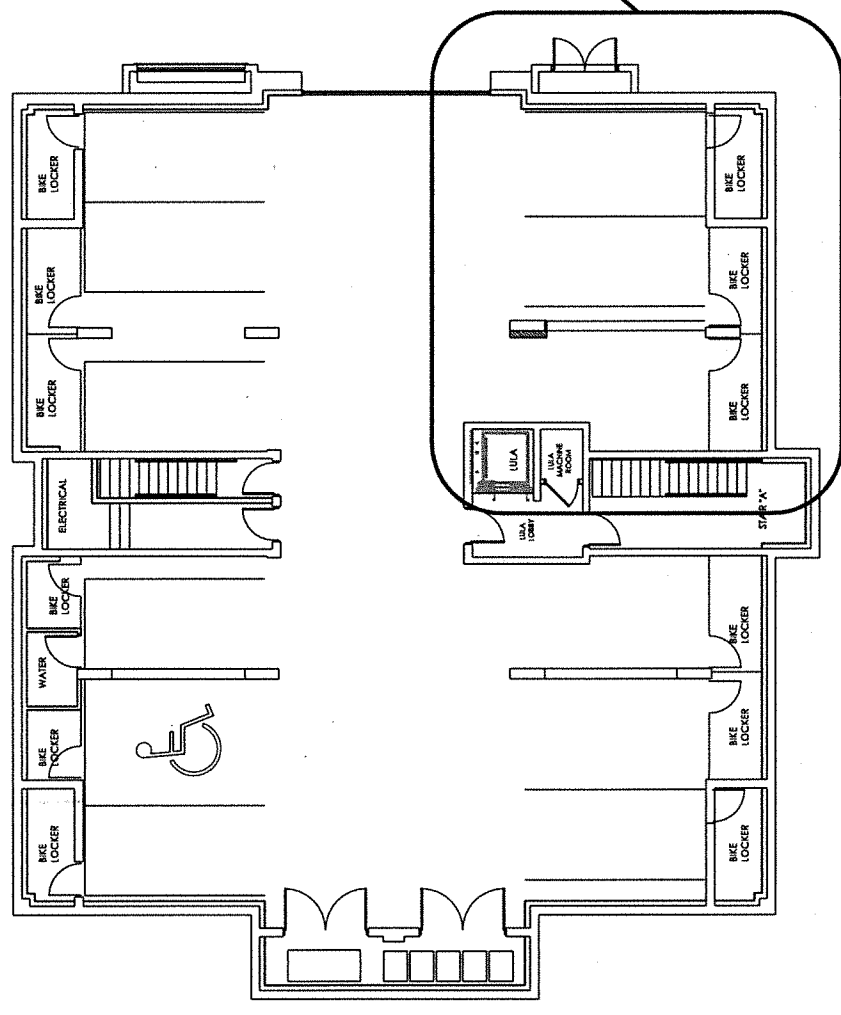


AS-CONSTRUCTED COLUMN LOCATION  
 COLUMN LOCATION AS PER PLAN

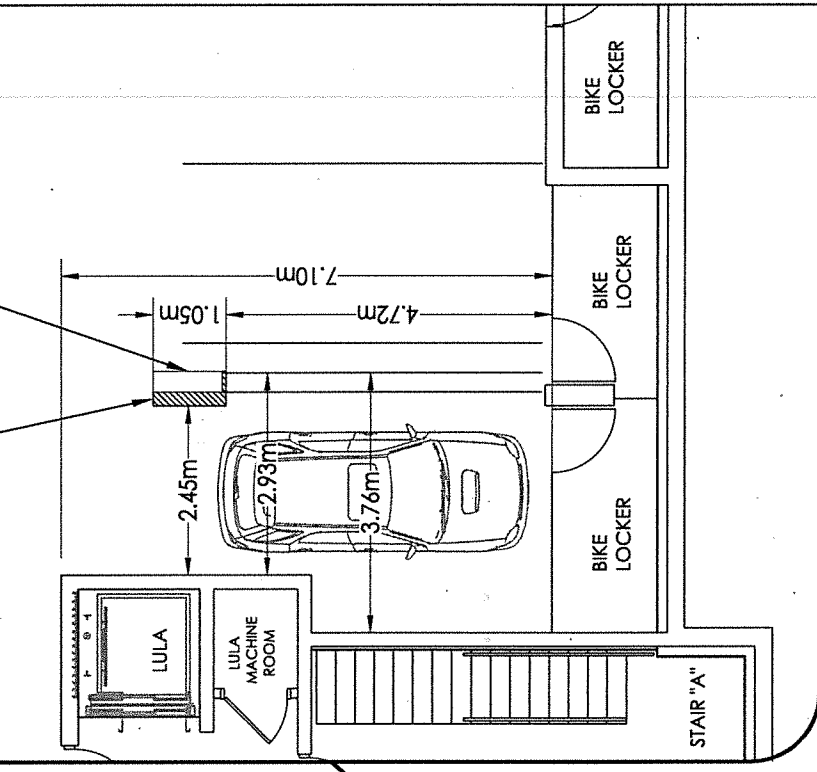

1 REVISED PARKING SPACE  
 A01 1:75

November 2019  
 160401530

Client/Project  
 KOL CONDOMINIUMS  
 210 LIVERY STREET  
 BUILDING A  
 Figure No. A01  
 Title PARKING GARAGE

Committee of Adjustment  
 NOV 21 2019  
 City of Ottawa

Notes

Legend

**Stantec**  
 Stantec Consulting Ltd.  
 400 - 1331 Clyde Avenue  
 Ottawa ON  
 Tel. 613.722.4420  
 www.stantec.com

